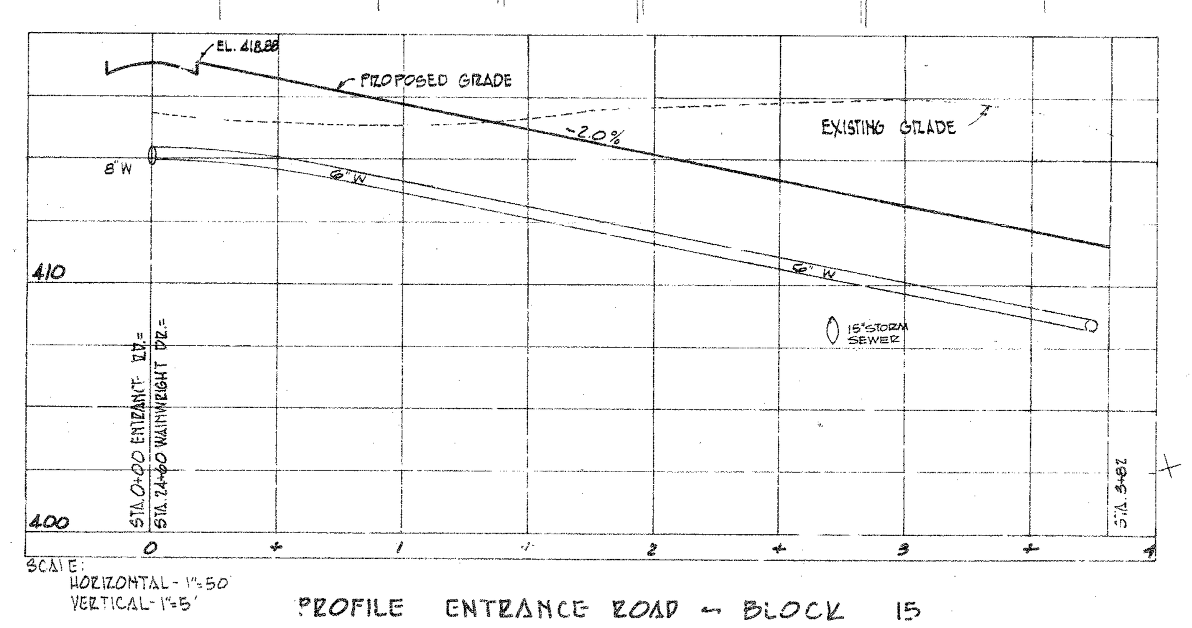

PROFILE ENTRANCE ROAD – BLOCK 15

ADDITION TO SECTION ONE

AS BUILT

BLOCK 15 PART II

ARCHITECT: CHLOETHIEL W. SMITH

REVISIONS	
DATE	DESCRIPTION
11/1/65	EXIST. TREE LOCATION
11-16-66	ADD M.H. 42-A (STORM)

RESTON
Centreville Magisterial District
Fairfax County
Virginia

Reston Engineering Division

SCALE 1" = 20'
DATE 9/1/67
Des. By
Drn. By
Ck. By

Sheet 2 of 2